



Clune Construction Company LP
10 South Riverside Plaza Suite 2200
Chicago IL 60606

Transmittal No: TRN0253

PROJECT: Litowitz Family Offices

To: Clune Construction Company LP
10 South Riverside Plaza Suite 2200
Chicago IL 60606

ATTN: Adam Sienkiewicz

DATE: 02/19/2024

SUBMITTAL: 102219.004-ChiLabs 6th Floor Elevator Entrance & Board Room

DUE DATE:

JOB: 221895

WE ARE SENDING:		SUBMITTED FOR:		ACTION TAKEN:	
☒	Shop Drawings	☐	Approval	☐	Approved as Submitted
☐	Letter	☐	Your Use	☐	Approved as Noted
☐	Prints	☐	As Requested	☐	Returned After Loan
☐	Change Order	☐	Review and Comment	☐	Resubmit
☐	Plans			☐	Submit
☐	Samples	SENT VIA:		☐	Returned
☐	Specifications	☒	Attached	☐	Separate Cover
☐	Other:	Other: N		☐	Other:
☐	Submittal:			☐	

Line	Package	Submittal Item #	Sub Spec Section	Cycle	QTY	Date	Description	Status
1	102219.004	102219.066		2		02/19/2024	Sheet CHL01: 6th Floor Elevator Entry Shop Drawings	Approved
2	102219.004	102219.067		2		02/19/2024	Sheet CHL02: 6th Floor Elevator Entry Shop Drawings	Approved

REMARKS:

CC:

Signed: _____

Adam Sienkiewicz

Transmittal No: TRN0248

PROJECT: Litowitz Family Offices

DATE: 02/15/2024

To: Gensler Architecture, Design & Planning, P.C.
11 E Madison St Suite 300
Chicago IL 60602
USA

SUBMITTAL: 102219.004-ChiLabs 6th Floor Elevator Entrance & Board Room

DUE DATE: 02/22/2024

JOB: 221895

ATTN: Shane Mathewson

WE ARE SENDING:		SUBMITTED FOR:		ACTION TAKEN:	
☒	Shop Drawings	☒	Approval	☐	Approved as Submitted
☐	Letter	☐	Your Use	☐	Approved as Noted
☐	Prints	☐	As Requested	☐	Returned After Loan
☐	Change Order	☐	Review and Comment	☐	Resubmit
☐	Plans	☐		☐	Submit
☐	Samples	SENT VIA:		☐	Returned
☐	Specifications	☒	Attached	☐	Returned for Corrections
☐	Other:	Other: N		☐	Other:
☐	Submittal:			☐	

Line	Package	Submittal Item #	Sub Spec Section	Cycle	QTY	Date	Description	Status
1	102219.004	102219.066		2		02/15/2024	Sheet CHL01: 6th Floor Elevator Entry For Approval Shop Drawings	
2	102219.004	102219.067		2		02/15/2024	Sheet CHL02: 6th Floor Elevator Entry For Approval Shop Drawings	

REMARKS: These drawings are for the entrance portals, as requested.

CC:

Gensler
SUBMITTAL REVIEW

☒ **NO EXCEPTIONS TAKEN.**
☐ **MAKE CORRECTIONS AS NOTED.** Resubmittal not required unless Contractor cannot comply with corrections noted.
☐ **REVISE AS NOTED AND RESUBMIT.**
☐ **RESUBMIT PROPERLY.** Submittal not reviewed for reasons noted.
☐ **NOT REVIEWED.** Submittal not required by Contract Documents.
☐ **RECEIVED FOR CLIENT'S RECORD ONLY.** Submittal not reviewed.

Gensler has reviewed this Submittal, but only for the purpose of checking for conformance with the design intent expressed in the Contract Documents. Gensler's action on a specific item does not indicate approval of an assembly of which the item is a component, nor of an item as delivered and installed if it does not conform to the Contract Documents.

Contractor is responsible for checking for deviations between this Submittal and differing information or conditions in the Contract Documents and field conditions; for determining or substantiating the accuracy and completeness of other details such as dimensions and quantities; for substantiating instructions for installation or performance of equipment or systems designed by Contractor; for construction means, methods, techniques, schedules, sequences, procedures, and fabrication processes; for errors and omissions in Submittals; for coordination of the Work of the trades, safety precautions and performing the Work in a safe and satisfactory manner and in conformance with the Contract Documents.

If more than one submittal review stamp appears on this Submittal, the most stringent action and notations thereon apply. Signature of a submittal review stamp by Gensler or a consultant does not imply that it has reviewed work not within its professional discipline or scope of services.

v1 3/2012

By: SHANE MATHEWSON **Date:** Fri Feb 16, 2024
Project No: 21.0982.000
Submittal: 102219.004.02 - ChiLabs 6th Floor Elevator Entranc

Signed: _____
Adam Sienkiewicz

Submitted By:

**CHILAB
STUDIO**

2620 W. Washington Blvd.
Chicago, IL, 60612

ChiLab Production Drawings

Elevator Lobby & Board Room Entries

Sheet Title:

Format: 8.5x11



Drawn By: BS

Date: 2024-02-13

Version: 1

Scale: NTS

Sheet Number: CHL01

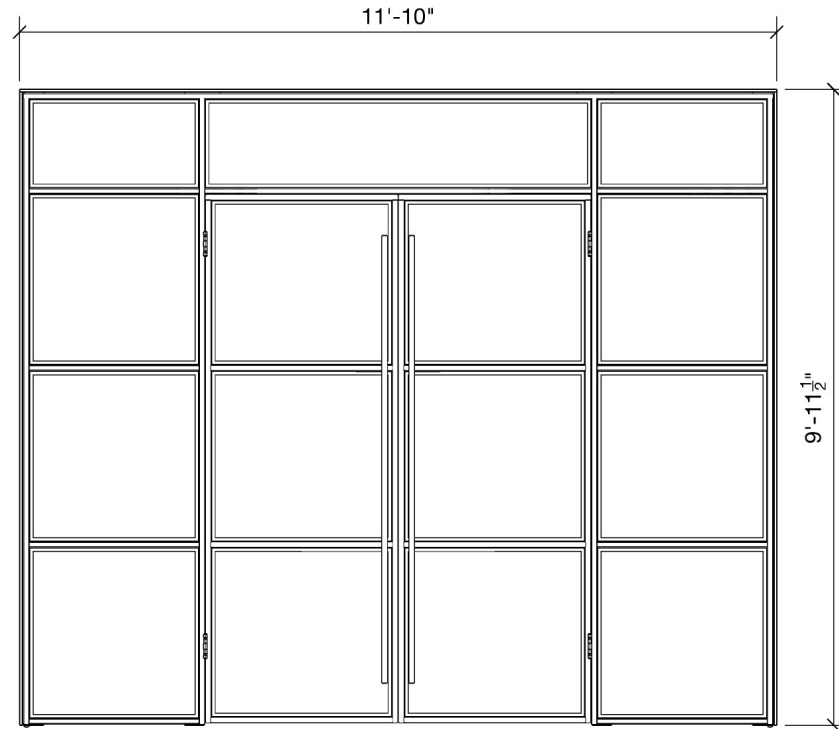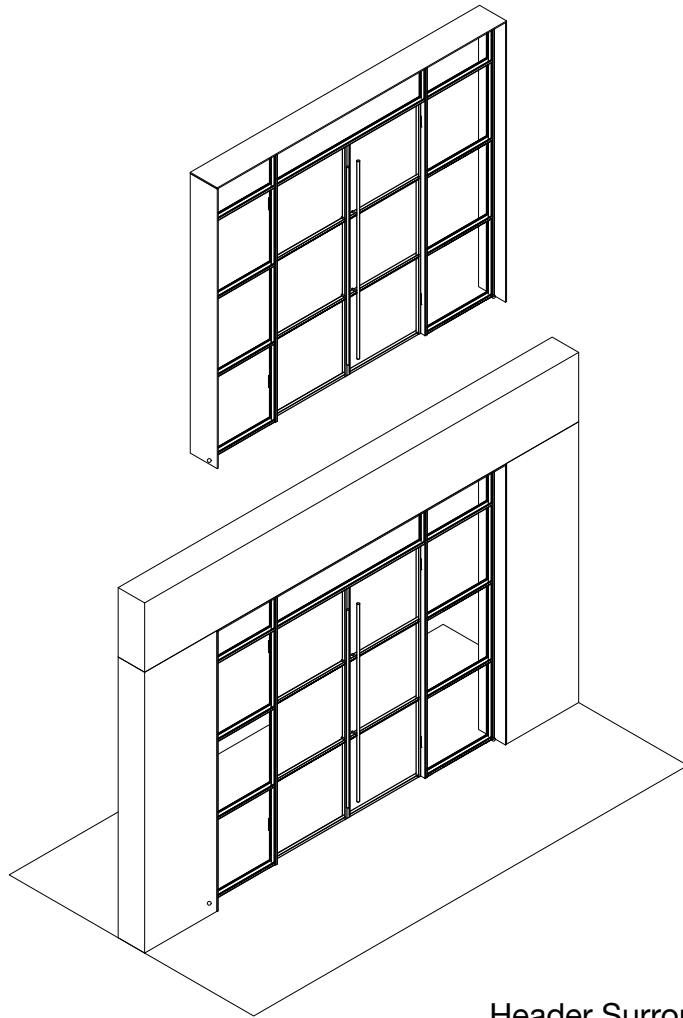



Header Surround
1/2" Steel Sheet - Bronze Finish
1/4" Reveal beyond brick (both sides)
Overall Width required per survey = 13 1/4"

Reviewed
Clune Construction Company
Project Number 221895
Shop Drawing # 102219.066
Date Submitted 2/15/24

Door Jam/Header Detail - Board Room East

NTS

01

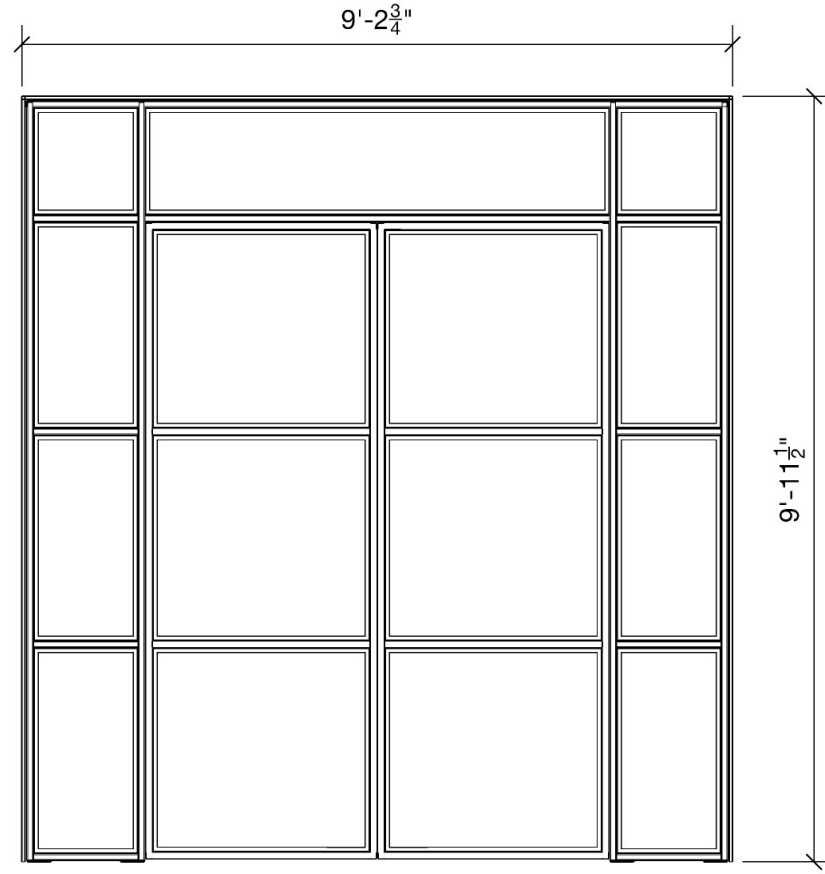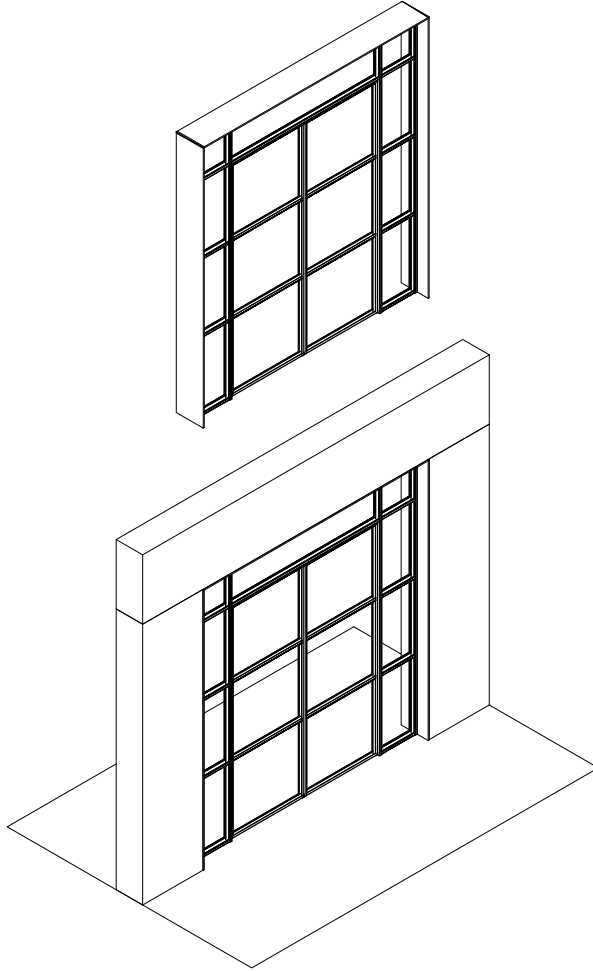

Header Surround
 1/2" gauge Steel Plate - Bronze Finish
 1/4" Reveal beyond brick (both sides)
 Overall Width required per survey = 13 1/4"

Reviewed
 Clune Construction Company
 Project Number 221895
 Shop Drawing # 102219.067
 Date Submitted 2/15/24

Door Jam/Header Detail - Board Room North

NTS

01

Sheet Title:	-
Format:	8.5x11
Drawn By:	BS
Date:	2024-02-13
Version:	1
Scale:	NTS
Sheet Number:	CHL02